

HISTORIC LANDMARK COMMISSION
SEPTEMBER 26, 2016
DEMOLITION AND RELOCATION PERMITS
HDP-2016-0625
1000 N. LAMAR BOULEVARD

PROPOSAL

Demolish a ca. 1946 gas station.

ARCHITECTURE

One-story, L-plan, masonry former gas station with Streamline Moderne detailing in the banded canopy with roof fins; single bay garage door openings.

RESEARCH

The building was constructed as a filling station for Young & Townsend, who operated their business there until around 1948. It was then a Texaco service station from the early 1950s until the mid-1970s, operated by Jack Stableford Pontiac. In the mid-1970s, the building became a used car lot, and Travis County purchased the building around 1980 for use as their vehicle maintenance shop.


STAFF COMMENTS

The building is not listed in any City survey.


STAFF RECOMMENDATION

Release the permit upon completion of a City of Austin Documentation Package, consisting of photographs of all elevations, a dimensioned sketch plan, and a narrative history, for archiving at the Austin History Center. While the building exhibits Streamline Modern details, it does not rise to the level of a historic landmark for its combination of architectural and historical significance.

LOCATION MAP

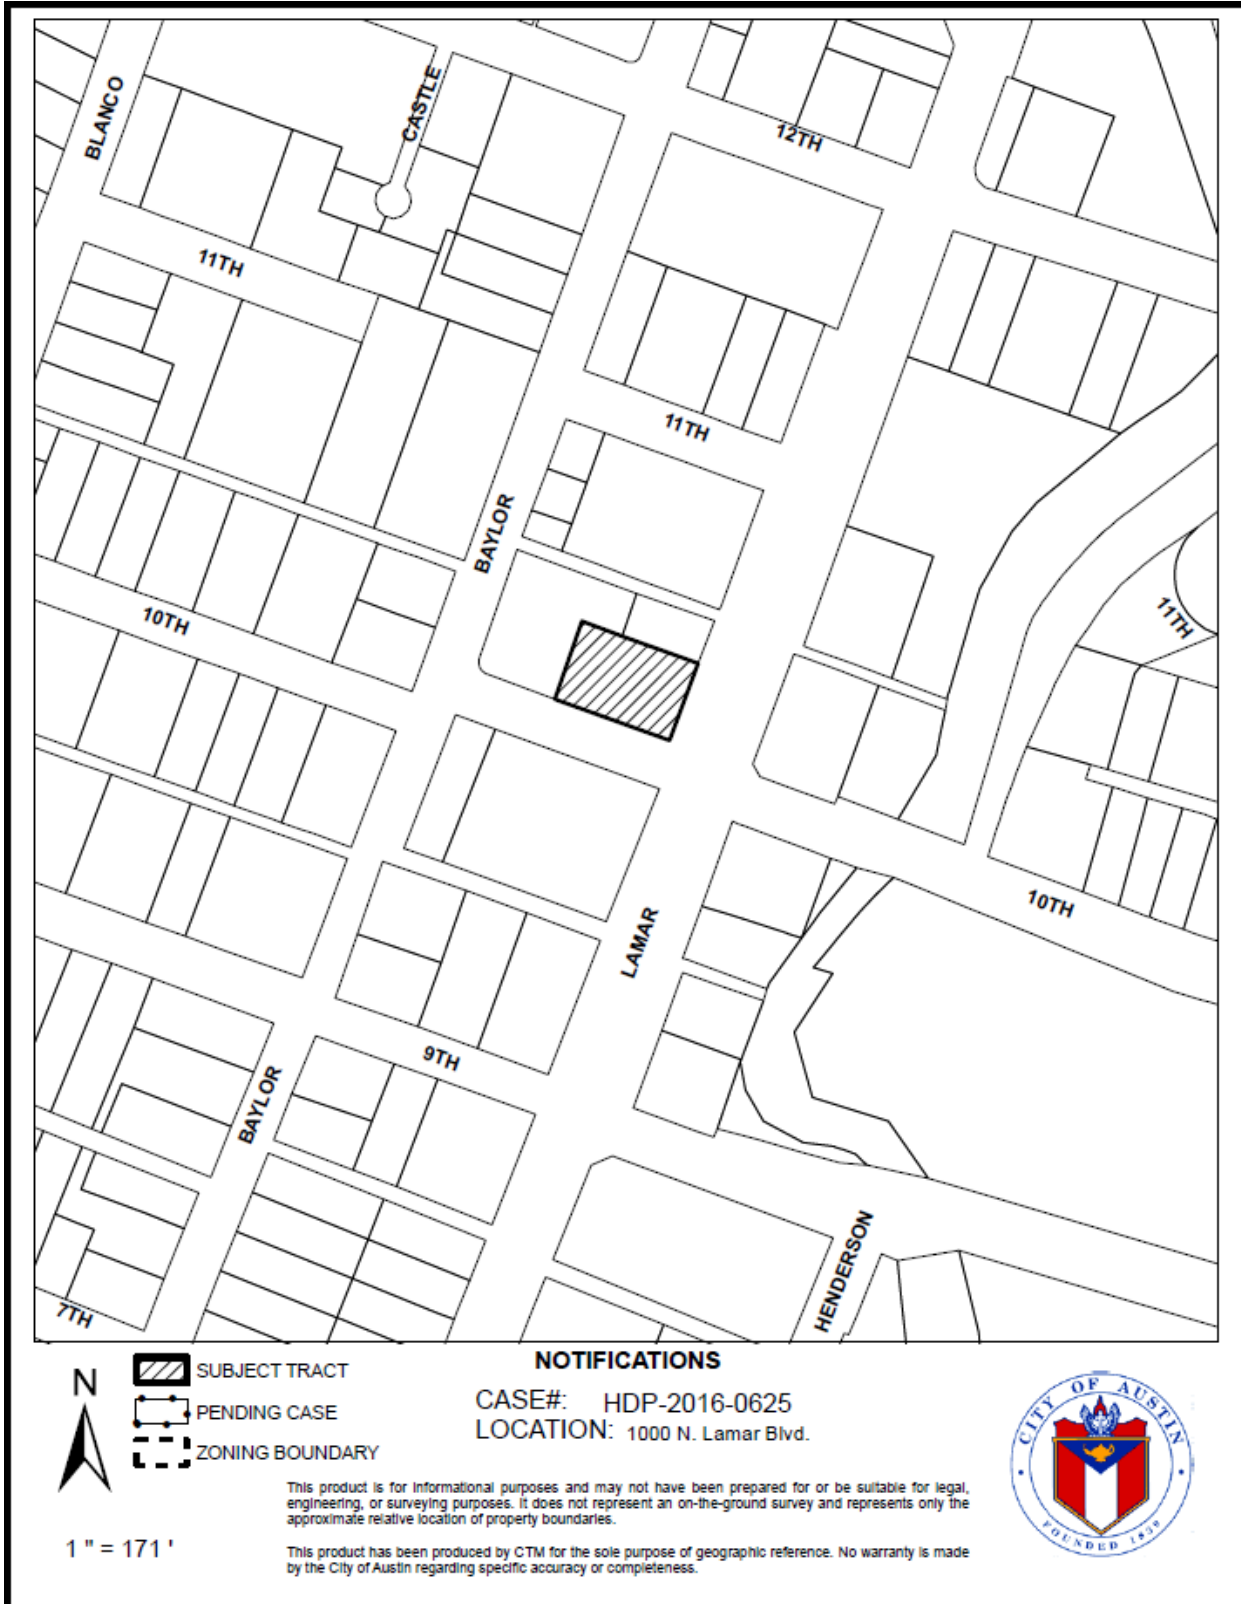

1000 N. Lamar Boulevard
ca. 1946

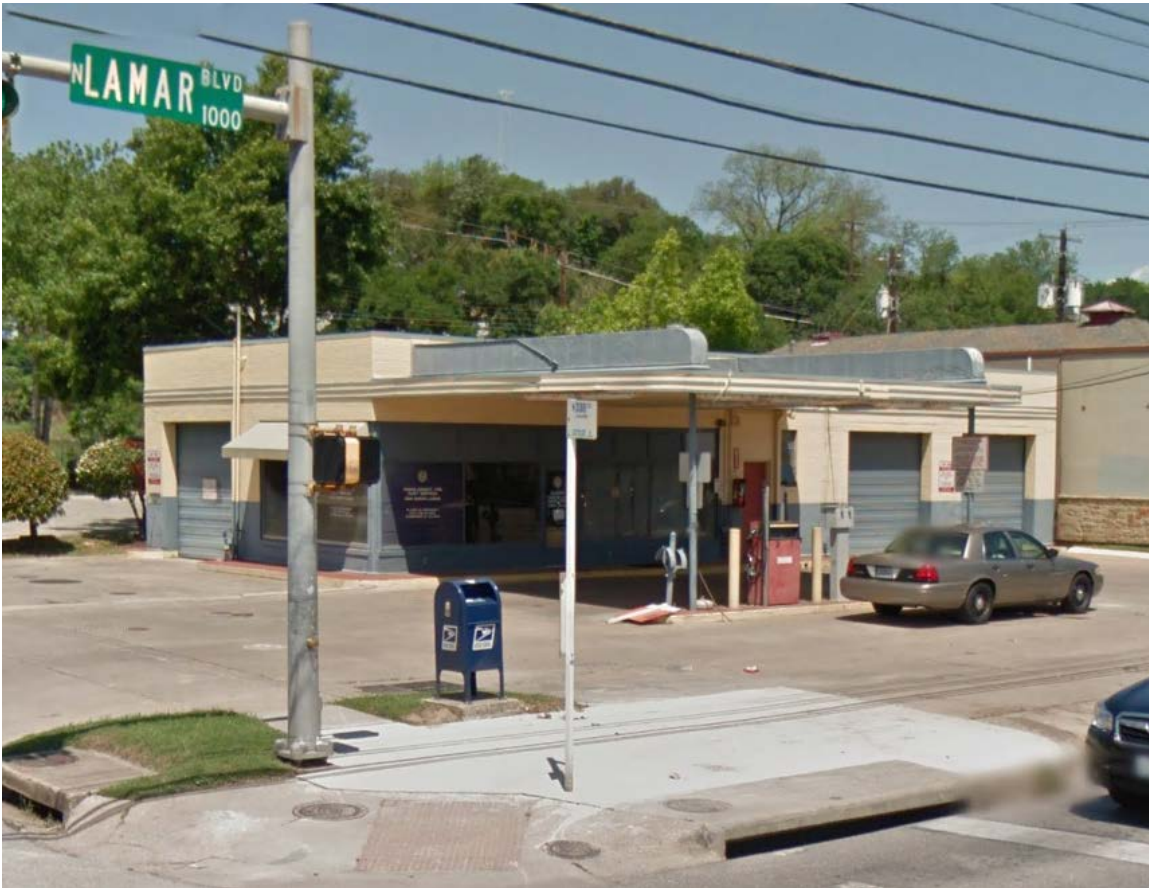

OCCUPANCY HISTORY
1000 N. Lamar Boulevard

City Directory Research, Austin History Center
By City Historic Preservation Office
September, 2016

- | | |
|---------|------------------------------------------------|
| 1992 | Travis County Vehicle Maintenance Shop |
| 1985-86 | Travis County Vehicle Maintenance Shop |
| 1981 | Travis County Vehicle Maintenance Shop |
| 1977 | Henry Moore Subaru, used cars |
| 1973 | Everett Frizzell Pontiac Texaco station |
| 1968 | Jack Stableford Pontiac Texaco service station |
| 1965 | Jack Stableford Pontiac Texaco service station |
| 1962 | Linnstaedter Texaco service station |
| 1959 | Lamar Texaco service station |

Benny E. Ray, proprietor

1955 Neelley & Branyon Texaco service station
Gordon Neelley and Olan M. Branyon, proprietors

1952 Gordon Neelley service station

1949 Vacant

1947 Young & Townsend filling station
W. Harvey Young and Claude H. Townsend, proprietors

1944-45 The address is not listed in the directory.

WATER SERVICE PERMIT

Austin, Texas

No. ^{DEC 43} 21524

Received of MOORE CONST. Co Date 11/27/45

Address 1000 LAMAR BLVD

Amount TEN & NO/100 \$ 10.00

Plumber P. M. LAMIER Size of Tap 1"

Date of Connection 12-8-45

Size of Tap Made 1 1/2"

Size Service Made 1 1/4"

Size Main Tapped 6"

From Front Prop. Line to Curb Cock 11'

From Prop. Line to Curb Cock 11 1/2'

Location of Meter CURB

Type of Box 20 X 24"

Depth of Main in St. _____

Depth of Service Line _____

From Curb Cock to Tap on Main _____

Checked by Engr. Dept. 72119 Z 1-11-46

No. Fittings	Size
1	Curb Cock
1	Elbow 3/4"
1	St. Elbow
1	Bushing 1 1/2 X 1"
1	Reducer 1 1/2 X 1 1/4 X 1 1/2
	Pipe
	Lead Comp
2	Nipples 1/2 X 1/2"
1	Union 1/2 CAP
1	Plug 1 1/2"
1	Tee 1 1/2"
1	Stop 1 1/2 X 1 1/2"
1	Box 20 X 24"
1	Lid 16 X 20"
	Valves
	Job No. 11328502
	Req. No. BENN

INDEXED

Repl. 5766 15652

Water service permit to Moore Construction Company for this address (1945)
Note: There are no other permits for this address.