SUBDIVISION REVIEW SHEET

CASE NO.: C8-2019-0112.1A

COMMISSION DATE: October 19, 2021

SUBDIVISION NAME: Twilight Gardens

ADDRESS: 8316 Twilight Terrace Dr.

APPLICANT: Twilight Estates LLC

AGENT: Jerome Perales (Perales Land Development LLC)

| ZONING: SF-1-CO-NP (single family residence) | NEIGHBORHOOD PLAN: West Oak Hill |
|---|----------------------------------|
| AREA: 17.92 acre (780,595.2 sf) | LOTS : 19 |
| COUNTY: Travis | DISTRICT: 8 |
| WATERSHED: Williamson Creek | JURISDICTION: Full Purpose |

VARIANCES: none

DEPARTMENT COMMENTS:

The request is for the approval of the Twilight Gardens subdivision composed of 19 lots on 17.92 acres.

STAFF RECOMMENDATION:

Staff recommends disapproval of the plat for the reasons listed in the comment report dated October 13, 2021, and attached as Exhibit C.

The plat does not comply with the criteria for approval in LDC 25-4-84(B) and staff recommends disapproval for the reasons listed in the attached comment report. An application that has been disapproved with reasons may be updated to address those reasons until the application expires. If the applicant submits an update to address the reasons for disapproval, that update will be presented to the Land Use Commission within fifteen days of submittal.

<u>CASE MANAGER</u>: Cesar Zavala <u>E-mail</u>: <u>cesar.zavala@austintexas.gov</u> **PHONE**: 512-974-3404

ATTACHMENTS


Exhibit A: Vicinity map Exhibit B: Proposed plat Exhibit C: Comment report dated October 13, 2021


EXHIBIT A

Location Map


8316 Twilight Terrace Dr, Austin, TX 78737




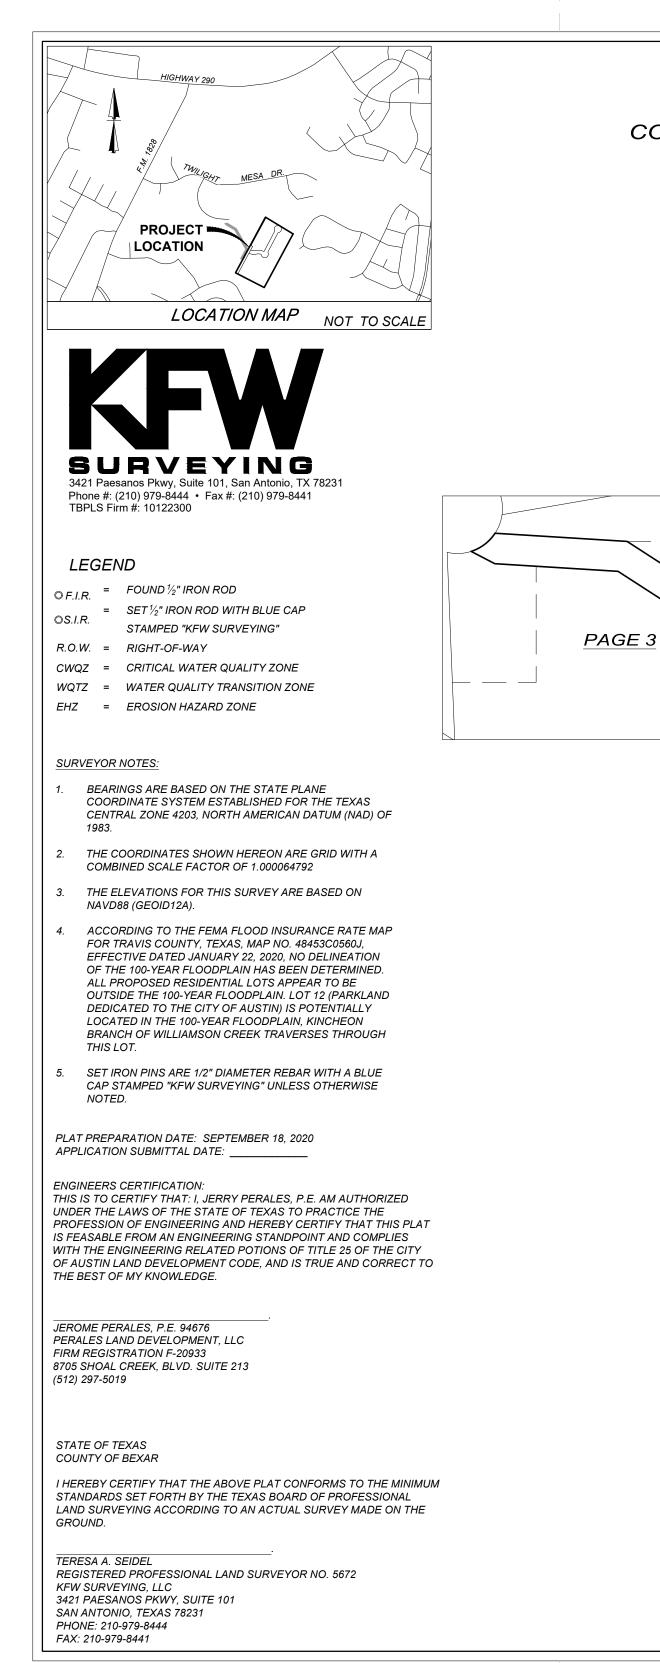


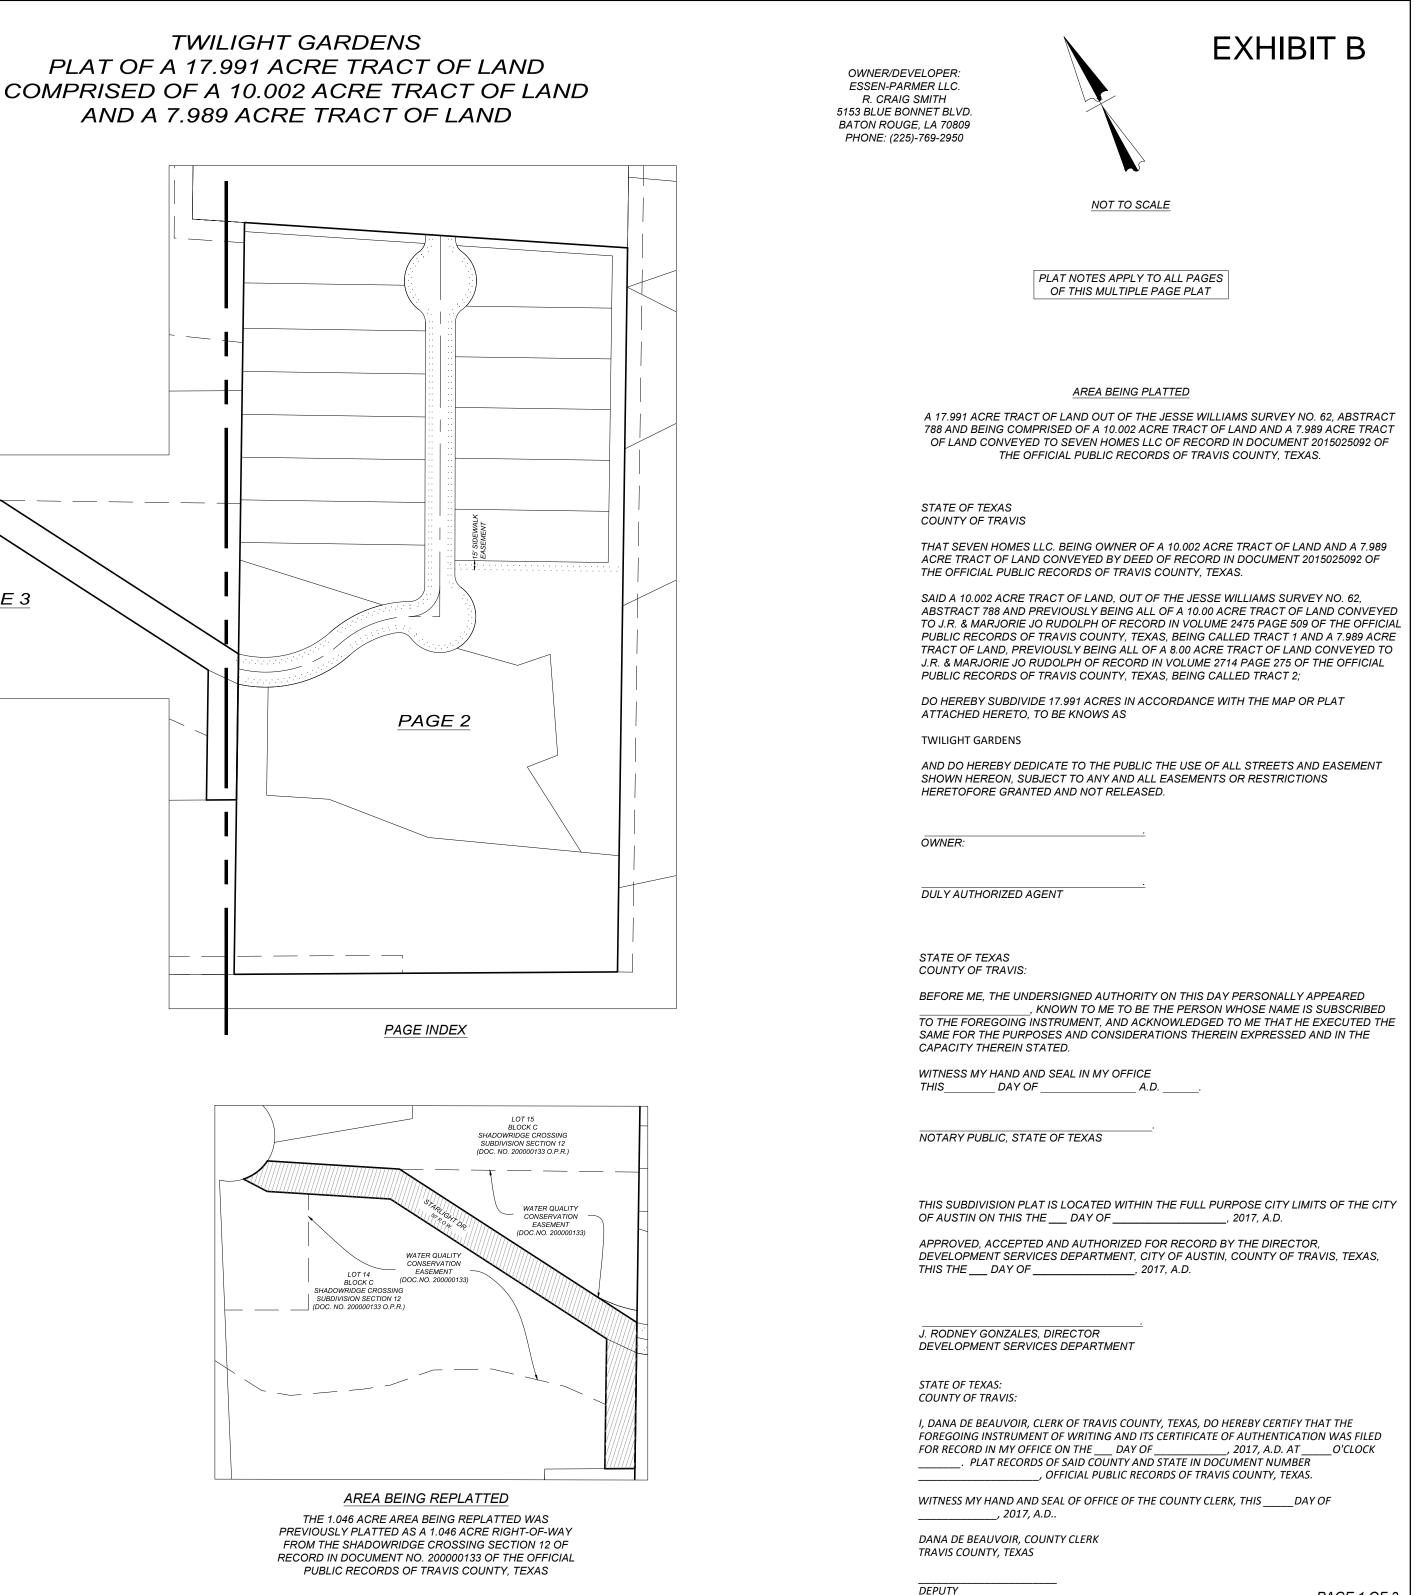


PAGE 1 OF 3

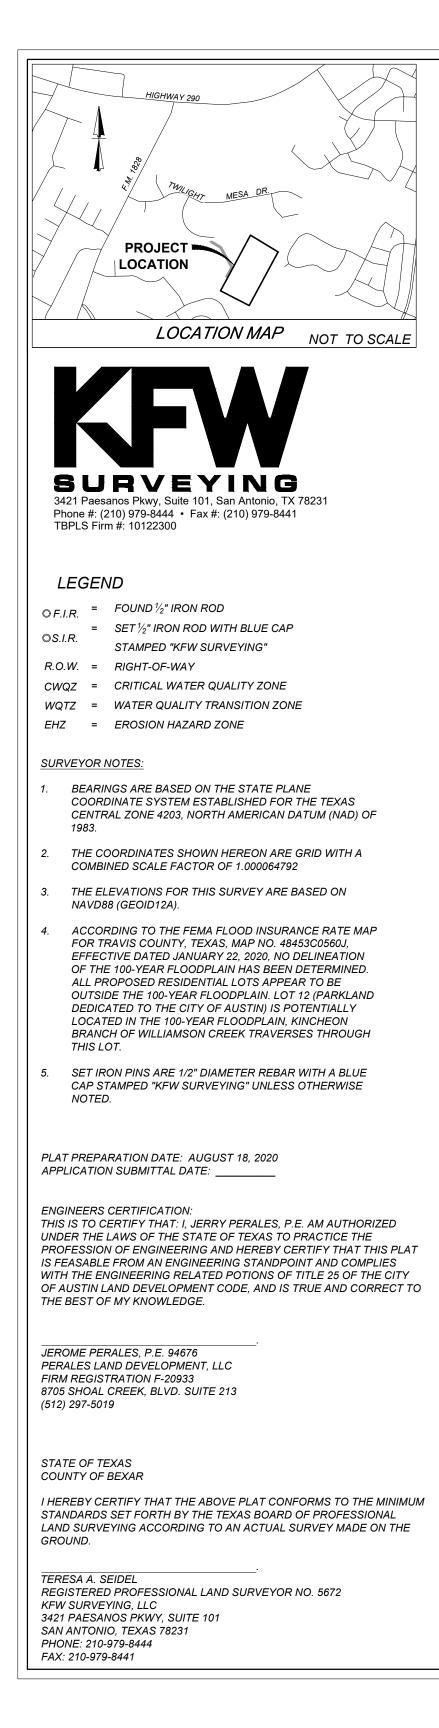


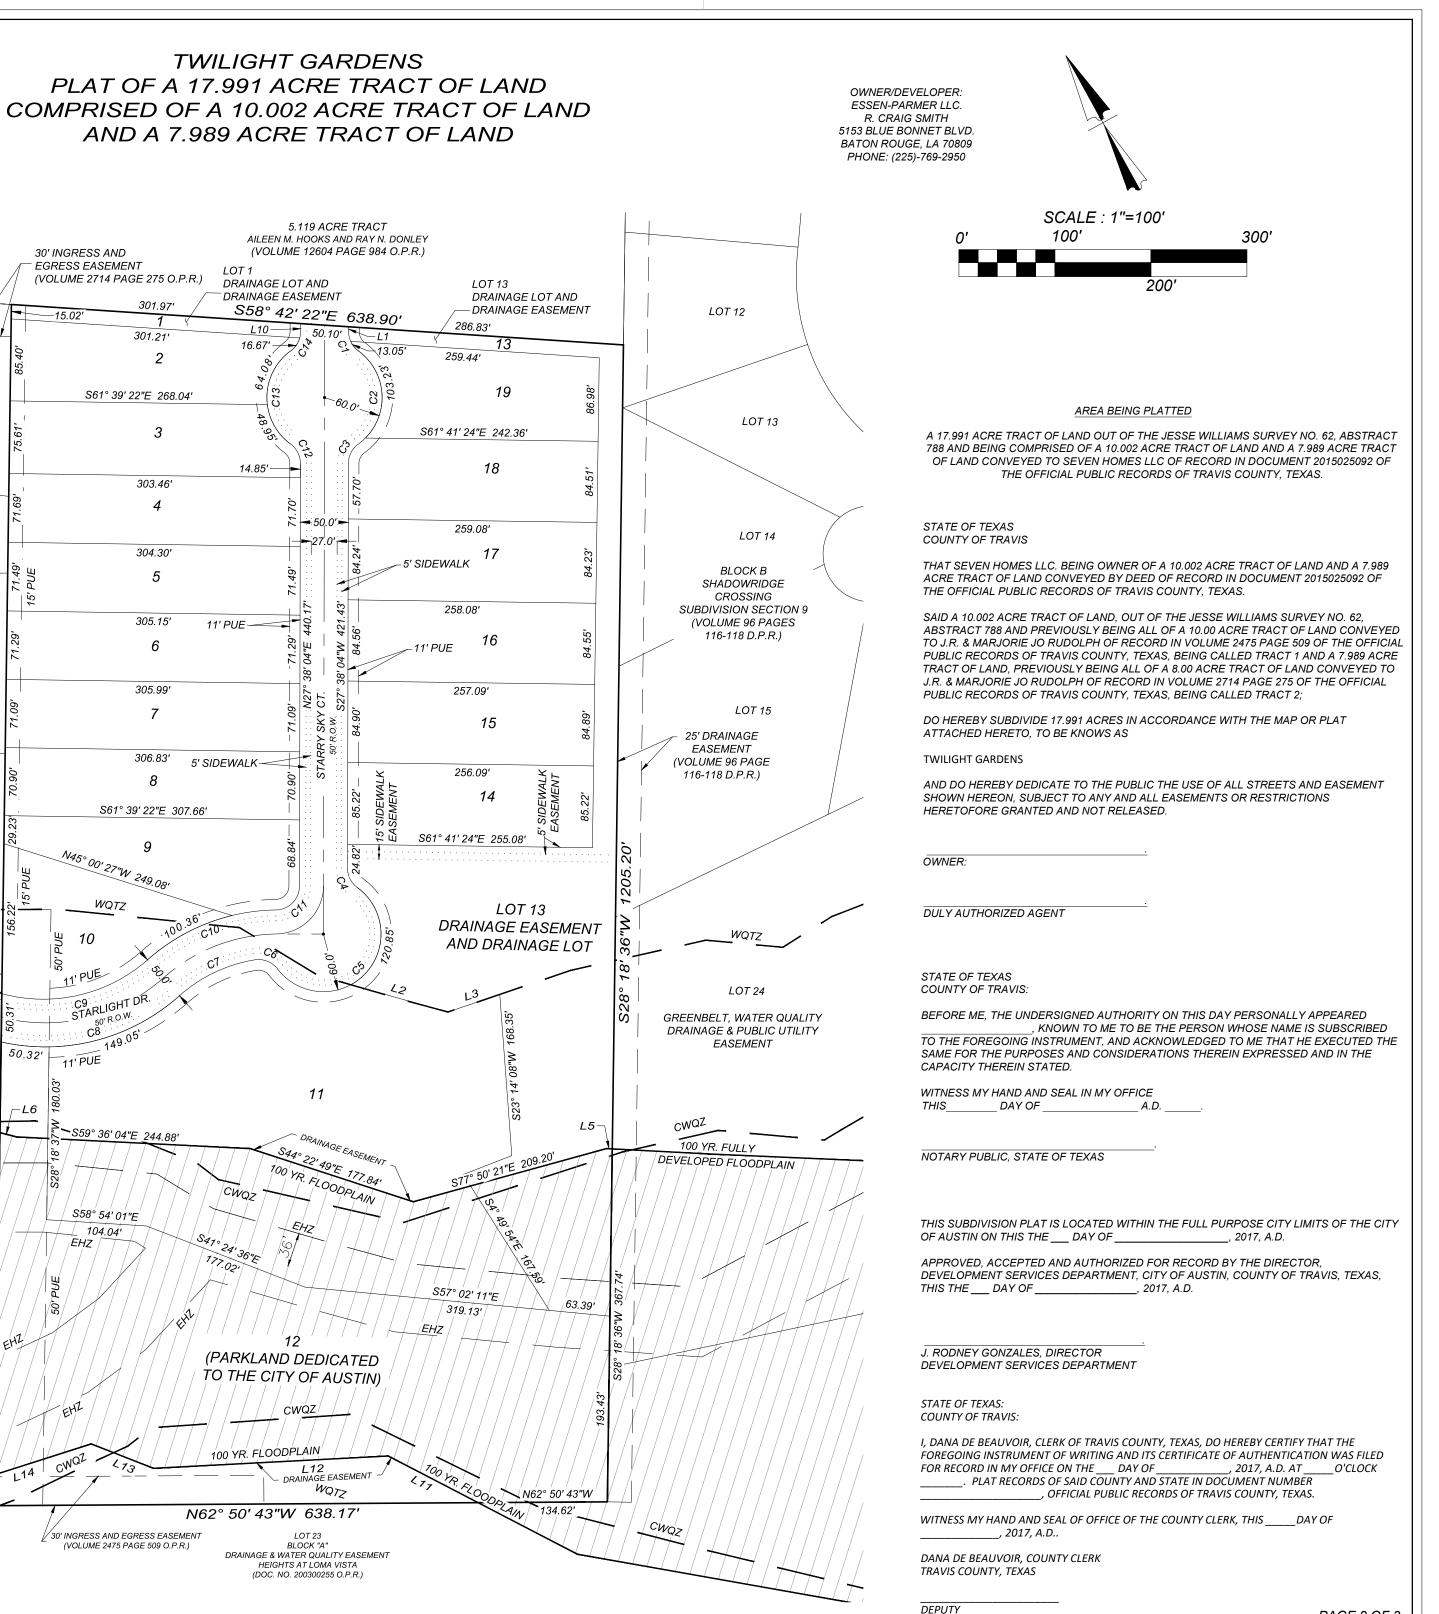

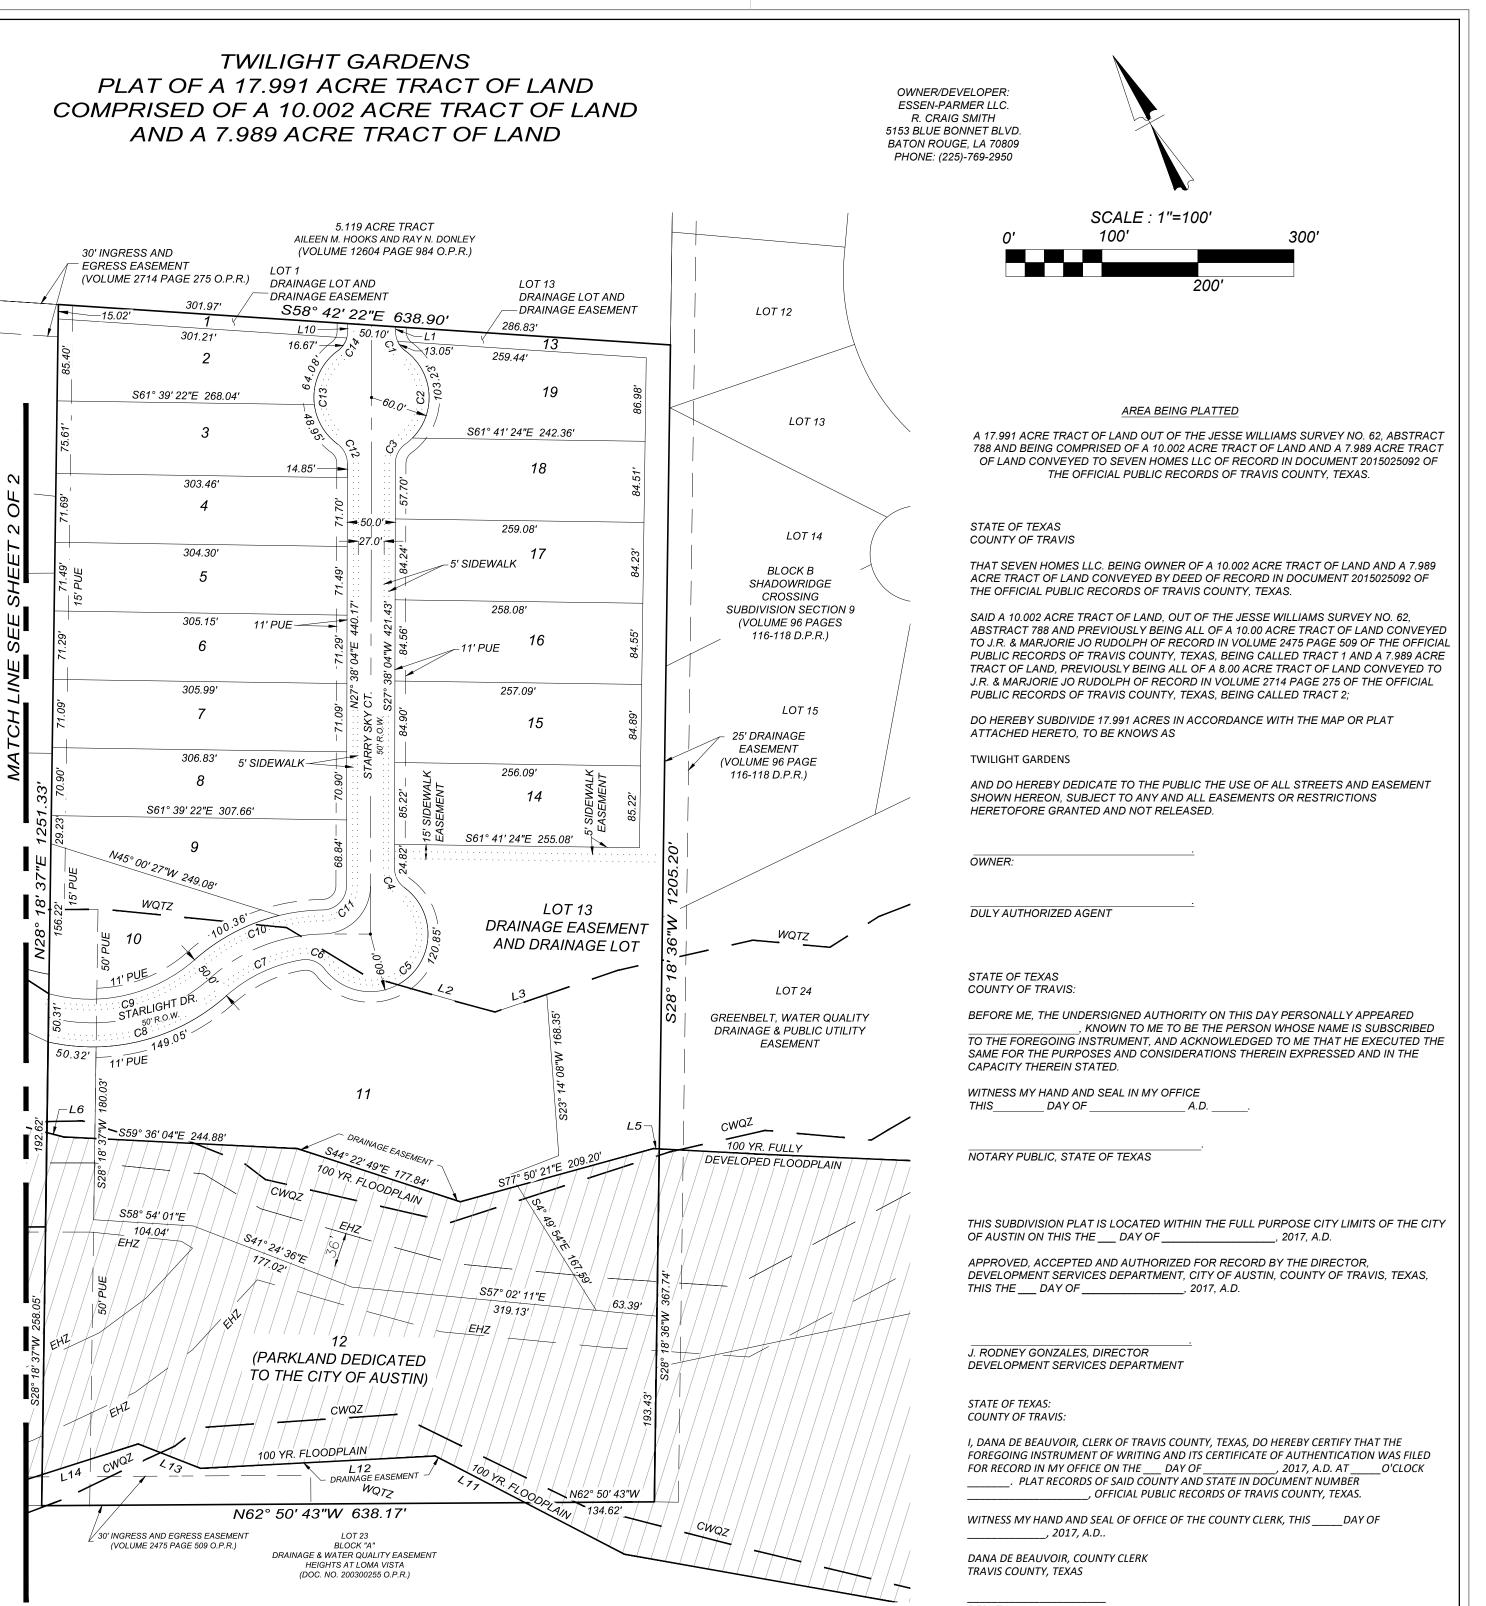

PAGE 2 OF 3

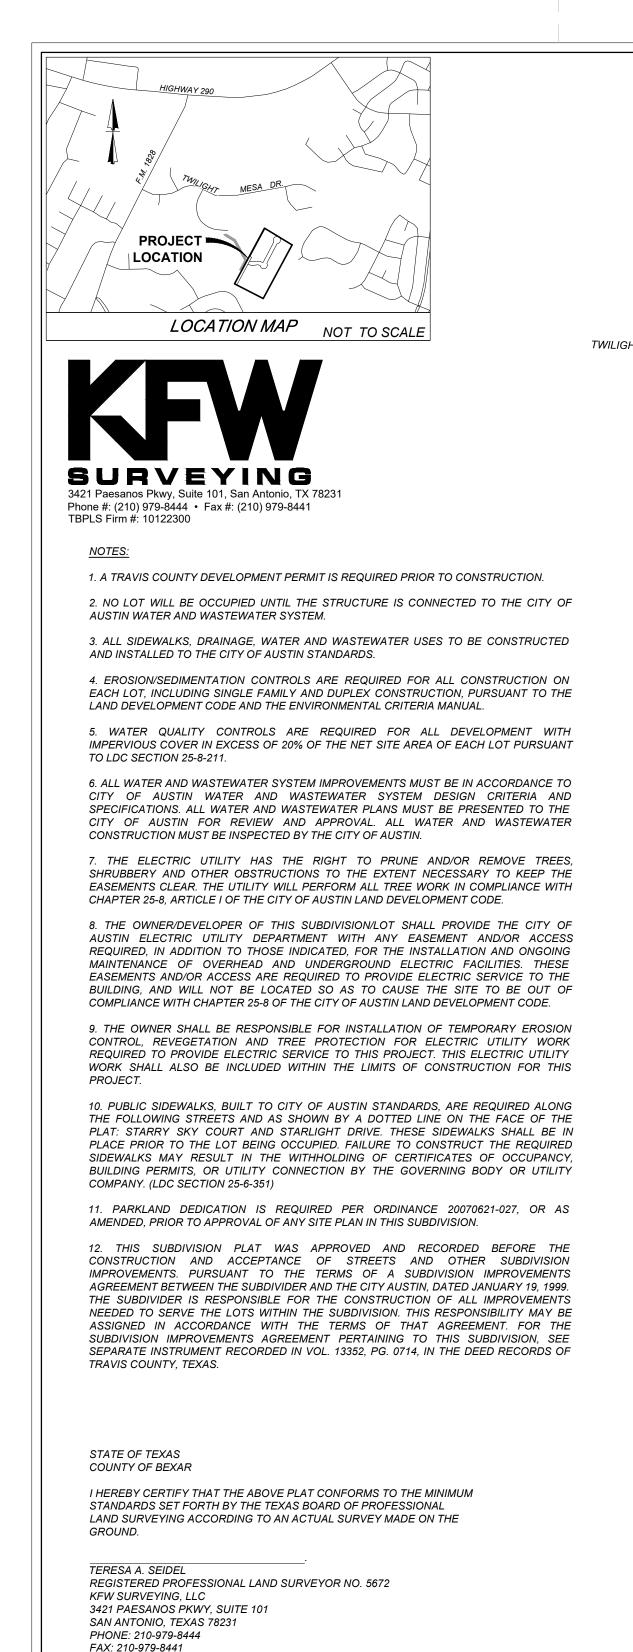

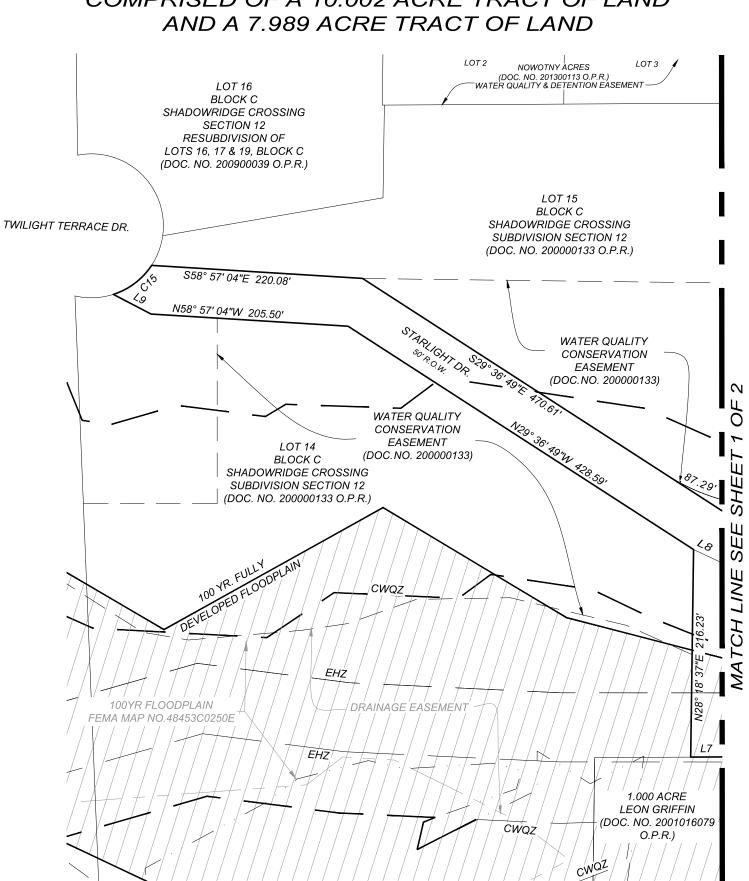

| LINE TABLE | | | | | |
|------------|---------|-------------|--|--|--|
| LINE # | LENGTH | DIRECTION | | | |
| L1 4.98' | | S27°38′04″W | | | |
| L2 104.95' | | S46°45'32"E | | | |
| L3 57.13' | | S81°12'15"E | | | |
| L4 | 54.25' | N83°43'31"W | | | |
| L5 | 5.76' | S59°27'29"E | | | |
| L6 | 17.33' | N47°55'47"W | | | |
| L7 | 50.01' | N62°48'21"W | | | |
| L8 | 54.88' | N37°19'56"W | | | |
| L9 | 44.29' | N34°58'34"W | | | |
| L10 | 8.17' | N27°38′04″E | | | |
| L11 | 105.36' | S35°00'50"E | | | |
| L12 | 245.15' | S65°28'47"E | | | |
| L13 | 69.37' | S41°01'01"E | | | |
| L14 | 105.20' | S80°09'35"E | | | |
| | | | | | |

| CURVE TABLE | | | | | | |
|-------------|---------|---------|------------|-------------|------------|--|
| Curve # | LENGTH | RADIUS | DELTA | CHORD BRG | CHORD DIST | |
| C1 | 23.55' | 25.00' | 53°58'05" | S00°39'01"W | 22.69' | |
| C2 | 113.03' | 60.00' | 107°56'10" | S27°38′04″W | 97.04' | |
| C3 | 23.55' | 25.00' | 53°58′05″ | S54°37'07"W | 22.69' | |
| C4 | 23.55' | 25.00' | 53°58′05″ | S00°39'01"W | 22.69' | |
| C5 | 205.78' | 60.00' | 196°30'20" | S71°55'10"W | 118.76' | |
| C6 | 27.01' | 25.00' | 61°53'22" | N40°46'30"W | 25.71' | |
| C7 | 87.91' | 155.00' | 32°29′53″ | N87°58'11"W | 86.74' | |
| C8 | 199.37' | 209.21' | 54°36′08″ | N77°01'43"W | 191.91' | |
| C9 | 162.32' | 164.46' | 56°33'00" | S75°32'26"E | 155.81' | |
| C10 | 146.48' | 205.00' | 40°56'24" | S83°44'53"E | 143.38' | |
| C11 | 38.87' | 25.00' | 89°05'15" | N72°10'41"E | 35.07' | |
| C12 | 23.55' | 25.00' | 53°58′05″ | N00°39'01"E | 22.69' | |
| C13 | 113.03' | 60.00' | 107°56'10" | N27°38′04″E | 97.04' | |
| C14 | 23.55' | 25.00' | 53°58′05″ | N54°37'07"E | 22.69' | |
| C15 | 50.97' | 74.92' | 38°58'45" | N80°18'15"E | 49.99' | |

TWILIGHT GARDENS PLAT OF A 17.991 ACRE TRACT OF LAND COMPRISED OF A 10.002 ACRE TRACT OF LAND



SCALE : 1"=100' 300' 100' 200' AREA BEING PLATTED A 17.991 ACRE TRACT OF LAND OUT OF THE JESSE WILLIAMS SURVEY NO. 62, ABSTRACT 788 AND BEING COMPRISED OF A 10.002 ACRE TRACT OF LAND AND A 7.989 ACRE TRACT OF LAND CONVEYED TO SEVEN HOMES LLC OF RECORD IN DOCUMENT 2015025092 OF THE OFFICIAL PUBLIC RECORDS OF TRAVIS COUNTY, TEXAS. N 13. PROPERTY OWNER SHALL PROVIDE FOR ACCESS TO DRAINAGE EASEMENTS AS MAY BE NECESSARY AND SHALL NOT PROHIBIT ACCESS BY GOVERNMENTAL AUTHORITIES. (LDC SECTION 25-7-152) 14. PRIOR TO CONSTRUCTION, EXCEPT DETACHED SINGLE FAMILY ON ANY LOT IN THIS SUBDIVISION, A SITE DEVELOPMENT PERMIT MUST BE OBTAINED FROM THE CITY OF AUSTIN. (LDC SECTION 25-5-1).

15. PRIOR TO CONSTRUCTION ON LOTS IN THIS SUBDIVISION, DRAINAGE PLANS WILL BE SUBMITTED TO THE CITY OF AUSTIN FOR REVIEW. RAINFALL RUN-OFF SHALL BE HELD TO THE AMOUNT EXISTING AT UNDEVELOPED STATUS BY PONDING OR OTHER APPROVED METHODS. ALL PROPOSED CONSTRUCTION OR SITE ALTERATION ON LOTS 3-4, BLOCK A REQUIRES APPROVAL OF A SEPARATE DEVELOPMENT PERMIT. (LDC SECTION 25-7-61)

16. NO BUILDINGS, FENCES, LANDSCAPING OR OTHER OBSTRUCTIONS ARE PERMITTED IN DRAINAGE EASEMENTS EXCEPT AS APPROVED BY THE CITY OF AUSTIN OR TRAVIS COUNTY. (LDC SECTION 25-7-3)

17. ALL DRAINAGE EASEMENTS ON PRIVATE PROPERTY SHALL BE MAINTAINED BY THE PROPERTY OWNER OR HIS/HER ASSIGNS.

18. DEVELOPMENT WHICH EXCEEDS 20% IMPERVIOUS COVER, WHEN CALCULATED AGAINST TOTAL PROPERTY, SHALL CONTROL THE INCREASED STORMWATER.

19. THE OWNER OF THIS SUBDIVISION, AND HIS OR HER SUCCESSORS AND ASSIGNS, ASSUMES RESPONSIBILITY FOR PLANS FOR CONSTRUCTION OF SITE IMPROVEMENTS WHICH COMPLY WITH APPLICABLE CODES AND REQUIREMENTS OF THE CITY OF AUSTIN. THE OWNER UNDERSTANDS AND ACKNOWLEDGES THAT PLAT VACATION OR REPLATTING MAY BE REQUIRED, AT THE OWNER'S SOLE EXPENSE, IF PLANS TO CONSTRUCT THE SITE DO NOT COMPLY WITH SUCH CODES AND REQUIREMENTS.

20. ADJOINERS SHOWN HEREON ARE PER TRAVIS COUNTY APPRAISAL DISTRICT RECORDS AND OFFICIAL PUBLIC RECORDS OF TRAVIS COUNTY, TEXAS.

21. ZONING: SF-1-CO-NP

LAND USE SINGLE FAMILY RESIDENTIAL

| TOTAL SITE AREA | = | 17.92 AC | / | 7,83,679 SF | = | 100% | |
|--|---|----------|---|-------------|---|-------|--|
| NET SITE AREA | = | 9.48 AC | / | 4,12,796 SF | = | 52.7% | |
| ALLOWABLE IMPERVIOUS COVER IN WQTZ | = | 0.00 AC | / | 0 SF | = | 0.0% | |
| ALLOWABLE IMPERVIOUS COVER IN UPLAND ZONE | = | 2.37 AC | / | 1,03,199 SF | = | 25.0% | |
| ALLOWABLE IMPERVIOUS COVER | = | 2.37 AC | / | 1,03,199 SF | = | 25.0% | |
| IMPERVIOUS COVER OF RIGHT OF WAY | = | 0.22 AC | / | 9, 583 SF | = | 2.3% | |
| IMPERVIOUS COVER OF SUBDIVISION IMPROVEMENTS | = | 0.06 AC | / | 2, 449 SF | = | 0.6% | |
| TOTAL ASSUMED BUILDING COVERAGE | = | 1.95 AC | / | 85, 000 SF | = | 20.6% | |
| TOTAL IMPERVIOUS COVER OF ROW AND SUBDIVISION IMPROVEMENTS | = | 0.28 AC | / | 12,032 SF | = | 2.9% | |
| IMPERVIOUS COVER IN UPLAND ZONE | = | 2.00 AC | / | 87032 SF | = | 21.1% | |
| TOTAL ASSUMED IMPERVIOUS COVER | = | 2.23 AC | / | 97,032 SF | = | 23.5% | |
| | | | | | | | |

LOT SIZE SUMMARY TABLE

| LOTS > 3 ACRES = 1 LOTS > 1 ACRES AND ≤ 3 ACRES = 0 | LOT IMPERVIOUS COVER SUMMARY TABLE | |
|--|--|---------------------|
| LOTS > 15.000 SF AND \leq 1 ACRES = 15 | LOTS > 3 ACRES = 10000 | 10000 SF ASSUMED IC |
| $LOTS > 10,000 \text{ SF AND} \le 15,000 \text{ SF} = 0$ | LOTS > 1 ACRES AND \leq 3 ACRES = 0 | 7000 SF ASSUMED IC |
| $\leq 10.000 \text{ SF} = 0$ | LOTS > 15,000 SF AND ≤ 1 ACRES = 75000 | 5000 SF ASSUMED IC |
| SUBTOTAL NUMBER OF LOTS = 16 | LOTS > 10,000 SF AND ≤ 15,000 SF = 0 | 3500 SF ASSUMED IC |
| DRAINAGE FACILITY LOT = 2 | $\leq 10,000 \text{ SF} = 0$ | 2500 SF ASSUMED IC |
| <i>ROW</i> = 1 | 85000 | |
| PARKLAND DEDICATION = 1 | *ACCORDING TO LDC 25-8-64 | |
| TOTAL NUMBER OF LOTS = 20 | | |

22. STREETS WILL BE CONSTRUCTED TO THE CITY OF AUSTIN STANDARDS. LDC 25-6-171(a).

23. THE CRITICAL ROOT ZONE OF ALL PROTECTED SIZE TREES TO REMAIN THAT ARE AFFECTED BY THE PAVING IN THE ROW SHALL HAVE NO CUTS OR FILL GREATER THAN 4". ALL DIGGING WILL BE DONE BY HAND AND AIR SPADE.

ENGINEERS CERTIFICATION:

THIS IS TO CERTIFY THAT: I, JERRY PERALES, P.E. AM AUTHORIZED UNDER THE LAWS OF THE STATE OF TEXAS TO PRACTICE THE PROFESSION OF ENGINEERING AND HEREBY CERTIFY THAT THIS PLAT IS FEASABLE FROM AN ENGINEERING STANDPOINT AND COMPLIES WITH THE ENGINEERING RELATED POTIONS OF TITLE 25 OF THE CITY OF AUSTIN LAND DEVELOPMENT CODE, AND IS TRUE AND CORRECT TO THE BEST OF MY KNOWLEDGE.

JEROME PERALES, P.E. 94676 PERALES LAND DEVELOPMENT, LLC FIRM REGISTRATION F-20933 8705 SHOAL CREEK, BLVD. SUITE 213 (512) 297-5019

PAGE 3 OF 3

EXHIBIT C

CITY OF AUSTIN –DEVELOPMENT SERVICES DEPARTMENT SUBDIVISION APPLICATION – MASTER COMMENT REPORT

 CASE NUMBER:
 C8-2019-0112.1A

 REVISION #:
 00
 UPDATE:
 U0

 CASE MANAGER:
 Cesar Zavala
 PHONE #:
 512-974-3404

PROJECT NAME:Twilight GardensLOCATION:8316 TWILIGHT TERRACE DR

SUBMITTAL DATE: September 20, 2021 REPORT DUE DATE:October 14, 2021 FINAL REPORT DATE: October 13, 2021

STAFF REPORT:

This report includes all staff comments received to date concerning your most recent subdivision application submittal. The comments may include requirements, recommendations, or information. The requirements in this report must be addressed by an updated submittal. The subdivision application will be approved when all requirements from each review discipline have been addressed. If you have any questions, concerns or if you require additional information about this report, please contact your case manager at the phone number listed above or by using the contact information listed for each reviewer in this report.

Any change to the plan/plat shall not cause noncompliance with any applicable code or criteria. In addition, any change to the plat may trigger new comments.

UPDATE DEADLINE INFORMATION (LDC 25-4-56; 25-4-82):

All comments must be addressed by filing an updated submittal prior to the update deadline of Otherwise, the application will expire. If this date falls on a weekend or City of Austin holiday, the next City of Austin workday will be the deadline.

Extension of Review Period, Extension of Update Deadline and Tolling of Application Period do not apply to applications for preliminary plan, plat or subdivision construction plans (LDC 25-1-88; 25-1-89; 25-1-90).

UPDATE SUBMITTAL INSTRUCTIONS (LDC 25-1-83):

- 1. Applicants must make an appointment with Intake Staff (974-1770) in order to submit an update.
- 2. Your update must include the following items:
 - a. This report
 - b. The revised plat/plan in pdf format
 - c. A letter that addresses each comment in the master comment report
- 3. Updates must be submitted on an approved submittal date, between the hours of 8:30 am and 4:00 pm. Refer to the submittal calendar for a list of approved submittal dates.

IMPORTANT NOTICE: the City of Austin Mayor and Travis County Judge COVID orders that suspended deadlines are set to end on December 31, 2021. Unless the Covid orders are extended, applications or determinations will begin expiring again on or after January 1, 2022. Please review the coversheet of the most recent staff report to find the expiration date. FYI: Preliminary Plan and Final Plat applications expire after 90 days and Subdivision Construction Plans expire after 1 year unless the application has been approved.



REVIEWERS: Planner 1 : Cindy Edmond AW Utility Development Services : Bradley Barron 911 Addressing : Jorge Perdomo Drainage Engineering : David Marquez Environmental : Pamela Abee-Taulli Flood Plain : Joydeep Goswami PARD / Planning & Design : Justin Stewart Site Plan Plumbing : Juan Beltran Subdivision : Cesar Zavala Water Quality : David Marquez Wetlands Biologist : Ana Gonzalez

Electric Review - Andrea Katz - 512-322-6957

No Review Required. Out of Austin Energy service area, served by Pedernales Electric Cooperative, Inc.

ATD Engineering Review - Sydnie Fiocca - 512-978-1670

No comments at this time.

Drainage Engineering Review - David Marquez - 512-974-3389

DE1 Update the engineering report to reflect the current site and the calculations for the current site and also the correct water quality methods being used.

DE2 Ensure the calculations are using Atlas 14 conditions as this will modify the sizing of your pond. For drainage, fully developed conditions are to be assumed in sizing of the pond and drainage infrastructure. (For water quality pond sizing, offsite flows can be assumed at 0% as you are not required to treat but pond sizing should be sized for it if draining to the ponds. Water quality can also use LDC 25-8-64 for impervious cover assumptions) Also account for sizing of a splitter box as it is required in the Barton Springs Zone.

DE3 Submit fiscal estimate for pond cost as the cost will be the total cost of the ponds (per fiscal policy) plus the percent required by ECM 1.2.2.1E.

DE4 It looks like the second portion of note 15 can be removed.

DE5 Note 18 can be removed as note 15 addresses no adverse impact.

DE6 For note 21, the lot size summary table impervious cover can be put into the water quality section of the engineering report and can be removed from the plat as these are assumptions and not specific restriction required on the plat.

Environmental Review - Pamela Abee-Taulli - 512-974-1879

PLAT NOTES [LDC 25-1, Article 4]

EV 1 Add the following note: *"This site is subject to the City of Austin's Void and Water Flow Mitigation Rule."* [LDC 25-8, Subchapter A, Article 7; ECM 1.12.0, Appendix P-1]

EV 2 Remove the specific reference to Land Development Code sections shown in plat notes #13 regarding access to drainage easements, #15 regarding submittal of drainage plans to the City, and #16 regarding obstructions in the drainage easement. A subdivision final plat note should only reference the Land Development Code in general. [[LDC 25-1, Article 4]

EV 3 Remove the CWQZ & WQTZ delineation from the plat. Add the following note: *"Waterway setbacks as defined by the Land Development Code may be located on this property. Development is limited within waterway setbacks."* [LDC 25-8, Article 7]

EV 4 For all projects in the Barton Springs Zone, add the following note: "The maximum portion of any commercial, multi-family, or single family/duplex lot that may be established as turf or landscaped area is 15 percent. However, no lot shall be restricted to less than 2000 square feet of turf or landscaped area. Undisturbed natural areas or areas restored to natural conditions shall not be considered landscaped areas or turf." [LDC 25-8, Subchapter A, Article 13; ECM 1.6.9.2.E]

ESC FISCAL SURETY [LDC 25-1, Article 5; ECM Appendix S-1]

EV 5 Provide a conceptual erosion & sedimentation control plan along with the fiscal estimate for erosion/sedimentation controls and revegetation based on ECM Appendix S-1. A conceptual ESC plan is necessary to assess the accuracy of the ESC fiscal estimate. ESC fiscal surety must be posted with the City of Austin prior to Plat approval. Additional fiscal posting might be required at the time of subdivision construction plan ESC review.

- Sites with a limit of construction greater than one acre must include a \$3000 per acre LOC cleanup fee in the fiscal estimate. [LDC 25-8, Subchapter A, Article 5; ECM Appendix S-1]
- Sites with a limit of construction greater than 25 acres are required to show phasing of disturbance tailored to the specific site conditions. A phased ESC plan and phased fiscal estimate are required. [LDC 25-8, Subchapter A, Article 7, Division 4; ECM 1.4.4]
- The revegetation line-item quantity must equal the entire LOC area less any existing impervious cover proposed to remain and less proposed public streets and sidewalks. This is necessary in the event that construction ceases after vegetation has been removed from within the LOC. [LDC 25-8, Subchapter A, Article 5; ECM Appendix S-1]

Flood Plain Review - Joydeep Goswami - 512-974-3521

DATE REVIEWED: 10/12/21 UPDATE #: U0 FORMAL UPDATE REQUIRED.

Reviewer's Notes: A portion of the subject tract is located within the critical water quality zone (CWQZ) and erosion hazard zone (EHZ), which indicates a contributory drainage area of 64 acres (or greater). This is the threshold to establish a regulatory floodplain per DCM 1.2.6.

FP1. Please provide the following:

- a. Confirmation statement that the best available data was used to delineate the COA floodplain (DCM 1.2.6)
- b. Digital copy of the floodplain model and all associated backup data within a signed & sealed report (LDC 25-7-33 & 61; DCM 1.2.6)
- i. NOTE: A digital version of the report and all associated backup data may be emailed to Joydeep.Goswami@austintexas.gov.

Pursuant to compliance with Sections 307.1, 609.6, and 721.1 of the 2021 Uniform Plumbing Code, add a plat note that conveys the following: Each Lot within this subdivision shall have separate sewer taps, separate water meters, and their respective private water and sewer service lines shall be positioned or located in a manner that will not cross lot lines.

PARD / Planning & Design Review - Justin Stewart - 512-974-9475

Update: 0

PR 1: Parkland dedication will be required per City Code §25-1-601, as amended, prior to approval of this final plat. Thank you for showing the parkland along the creek. Please extend a finger of parkland up to the ROW for a unimproved or mulch trail, so the public can access the public land.

PR2: After this addition, please provide this review a table showing how much land is unencumbered, 100yr fld pln, 25 yr floodplain, within existing or proposed easements so this reviewer can calculate remaining fees under City Code §25-1-601.

PR3: Please confirm total number of units.

Subdivision Review - Cesar Zavala - 512-974-3404

- SR 1. Update the title of the plat to show with a larger font and show the acreage information in a smaller font below the title/name of the plat. 25-1-83 or 30-1-113
- SR 2. Show all lot and block numbers. 25-1-83 or 30-1-113
- SR 3. The plat must be printed on mylar that is no less than 18x24. 25-1-83 or 30-1-113
- SR 4. Revise the lines as follows: 25-1-83 or 30-1-113
 - The boundary line must be solid and the heaviest weighted line. Verify the boundary line accurately encompasses only the area inside the preliminary plan.
 - All proposed lot lines must be solid and the second heaviest line.
 - Easement lines (existing and proposed) must be broken, and a lighter weight than lot lines. The easement area may be shaded or hatched.
 - Lot lines outside but adjacent to the project must be broken and the lightest weight.
- SR 5. Remove the application submittal date information from the plat.
- SR 6. Update the sheets to show the plat drawing on the first page with the plat notes and signatures on the second page, also update the sheet numbering on the matchlines. The exhibit showing the sheet pages and the platted Starlight Dr. portion should be the last page. 25-1-83 or 30-1-113
- SR 7. One concrete monument is required to be placed at or near a major property corner if one is not located and shown within 1300 feet on previously recorded property. 25-4-131 or 30-2-131
- SR 8. Update the plat sheet set to only show one owner's preamble, notary for the owner, City of Austin and commission approval block, and Travis County annotation block. This information is not needed on each sheet.

- SR 9. Add the Case # in the bottom right hand corner of each sheet, C8-2019-0112.1A . 25-1-83 or 30-1-113
- SR 10. In the approval blocks change all applicable dates to 20___. 25-1-83 or 30-1-113
- SR 11. Verify the scale on the plat is correct. 25-1-83 or 30-1-113
- SR 12. Revise the owner's dedication block as follows and list the current owner of the property as listed in the provided deed.: 25-1-83 or 30-1-113, TX LGC 212.004(c)

That (owner) being the owner of that certain (acreage) tract of land out of the (survey/abstract) situated in ______ County, Texas, as conveyed by deed as recorded in Document No. (XX) of the official public records of ______ County, Texas, does hereby subdivide (XX) acres of land in accordance with the attached map or plat shown hereon, pursuant to Chapter 212 of the Texas Local Government Code, to be known as:

TITLE OF SUBDIVISION

And do hereby dedicate to the public, the use of the streets and easements shown hereon, subject to any easements and/or restrictions heretofore granted and not released.

SR 13. Add the Land Use Commission approval block. 25-1-83 or 30-1-113:

Accepted and authorized for record by the Land Use Commission of the City of Austin, Texas, on this, the _____day of _____20__.

Chair

Secretary

SR 14. Update the City of Austin approval block on the plat to show the case manager and current director's information: 25-1-83, 30-1-113 APPROVED, ACCEPTED AND AUTHORIZED FOR RECORD BY THE DIRECTOR, DEVELOPMENT SERVICES DEPARTMENT, CITY OF AUSTIN, COUNTY OF TRAVIS, THIS THE ____ DAY OF _____, 20__, AD.

Cesar Zavala for: Denise Lucas, Director Development Services Department

- SR 15. Show signatures of owner(s), notary public(s) with appropriate seals and dates. Print names under signatures with addresses. 25-1-83 or 30-1-113
- SR 16. Indicate the distance from the subdivision to the nearest intersection. 25-1-83 or 30-1-113
- SR 17. Provide a lot summary table near the legend. Indicate the acreage of the overall subdivision, the size of each lot (in square footage), and the number and total of each land use (open space, drainage, parkland, etc.) 25-1-83 or 30-1-113
- SR 18. Revise the engineer's certification 25-1-83 or 30-1-113

"I, (name of engineer), am authorized under the laws of the State of Texas to practice the profession of engineering and hereby certify that this plat is feasible from an engineering standpoint and complies with the engineering related portions of (Title 25/Title 30) of the City of Austin Land Development Code, and is true and correct to the best of my knowledge."

SR 19. Revise the surveyor's certification. 25-1-83 or 30-1-113

"I, (name of surveyor), am authorized under the laws of the State of Texas to practice the profession of surveying and hereby certify that this plat complies with the surveying related portions of (Title 25/Title 30) of the City of Austin Land Development Code, and is true and correct to the best of my knowledge, and was prepares from an actual on the ground survey of the property made under my direction and supervision."

SR 20. Add the following plat note 25-1-83 or 30-1-113

"Lot XX, Block YY will be maintained by the owner or his/her assigns. No residential development shall be allowed on this lot. If conveyed to a public entity or neighborhood organization, recreation facilities and rest areas may be constructed".

SR 21. If fiscal is not required to be posted, add the following note and delete Note 12: 25-1-83, 30-1-113

"By approving this plat, the City of Austin assumes no obligation to construct any infrastructure in connection with this subdivision. Any subdivision infrastructure required for the development of the lots in this subdivision is the responsibility of the developer and/or the owners of the lots. Failure to construct any required infrastructure to City standards may be just cause for the City to deny applications for certain development permits including building permits, site plan approvals, and/or certificates of occupancy."

SR 22. If fiscal is required, replace Note #12 with thes following note. The subdivision construction agreement (SCA) will be prepared by the fiscal officer. 25-1-83, 25-4-38, 25-4-84 or 30-1-113, 30-2-38, 30-2-84

"This subdivision plat was approved and recorded before the construction and acceptance of streets and other subdivision improvements. Pursuant to the terms of a Subdivision Construction Agreement between the subdivider and the City of Austin, Dated ______, 20___, the subdivider is responsible for the construction of all streets and facilities needed to serve the lots within the subdivision. This responsibility may be assigned in accordance with the terms of that agreement. For the Construction Agreement pertaining to this subdivision, see the separate instrument recorded in Doc#. ______, in the Official Public Records of County, Texas."

SR 23. Add a note listing any lot that will not have residential uses, such as open space lots or landscape lots, list the organization that will maintain these lots. Include that no residential uses are allowed on these lots.

SR 24. Verify that the information on the plat matches the preliminary plan. 25-1-83

AW Utility Development Services - Bradley Barron - 512-972-0078

AW1. <u>Per Utility Criteria Manual Section 2, §15-9, §25-4, §25-5, §25-9, and the Uniform Plumbing Code:</u> The landowner intends to serve each lot with City of Austin water and wastewater utilities. Each lot must have a separate water and wastewater utility connection and no existing or proposed plumbing may cross lot lines. The landowner, at own expense, will be responsible for providing the water and wastewater utility improvements, offsite main extensions, system upgrades, utility relocations and or abandonments to serve each lot.

AW2. <u>Per Utility Criteria Manual Section 2, §25-4, and the Uniform Plumbing Code:</u> Replace note 6 with the following note:

THE WATER AND WASTEWATER UTILITY SYSTEM SERVING THIS SUBDIVISION MUST BE IN ACCORDANCE WITH THE CITY OF AUSTIN UTILITY DESIGN CRITERIA. THE WATER AND WASTEWATER UTILITY PLAN MUST BE REVIEWED AND APPROVED BY AUSTIN WATER. ALL WATER AND WASTEWATER CONSTRUCTION MUST BE INSPECTED BY THE CITY OF AUSTIN. THE LANDOWNER MUST PAY THE CITY INSPECTION FEE WITH THE UTILITY CONSTRUCTION AW3. Per Uniform Plumbing Code:

There is a private lift station and force main within the boundaries of the proposed plat that will cross lot lines. Provide approval from Site Plan Plumbing review for proposed plat.

FYI. The landowner must pay the tap and impact fee once the landowner makes an application for a City of Austin water and wastewater utility tap permit.

Water Quality Review - David Marquez - 512-974-3389

WQ1 Remove note 5 or modify as this reference is outdated.

WQ2 Submit a slat tool to demonstrate the proposed pond size and infiltration allotted area is large enough for when the site plan comes in. Keep in mind setback requirements for irrigation area.

WQ3 submit a desktop study of the irrigation area to ensure the sizing of the infiltration area is large enough for the allotted space dedicated in the drainage easement for drainage and water quality. Feel free to reach out if you have any questions or want guidance.

Wetlands Biologist Review - Ana Gonzalez - 512-974-2929

WETL 1. **Update 0** Proposed plat does not meet approved preliminary by not including plat note regarding required CWQZ restoration.

911 Addressing Review - Jorge Perdomo - 512-974-1620

AD1: This plat review is Rejected;

AD2: STARLIGHT DR- duplicate, select another name

AD3: STARRY SKY CT- please update to STARRY SKY WAY to reflect as reserved

NOTE: Choose another name to replace STARLIGHT DR and avoid punctuation points

§25-4-155

end of report